SECTION 35, TWP. 27 S., RNG. 15 E., PINELLAS COUNTY, FLORIDA

LEGAL DESCRIPTION

LOTS 1, 2, 3, 34, 35 AND 36, BLOCK 5, CRYSTAL BEACH HEIGHTS, ACCORDING TO THE PLAT THEREOF AS RECORDED IN PLAT BOOK 3, PAGE 58, PUBLIC RECORDS OF PINELLAS COUNTY, FLORIDA, LESS AND EXCEPT ROAD RIGHT-OF-WAY.

FLOOD ZONE

THE ABOVE DESCRIBED PROPERTY APPEARS TO BE IN ZONE X, IN ACCORDANCE WITH THE FIRM MAP OF PINELLAS COUNTY, COMMUNITY NUMBER 125139 (MAP NUMBER 12103C-0057-H), MAP DATED AUGUST 24, 2021.

PREPARED FOR

SIX EXPANDED ENTERPRISES, LLC

NORTH

0 20 40 60

GRAPHIC SCALE
1 inch = 20 feet

SURVEY ABBREVIATIONS

A = ARC LENGTH
A/C = AIR CONDITIONER
ALUM = ALUMINUM FENCE
B.M. = BENCH MARK
ASPH = ASPHALT
BFE = BASE FLOOD ELEVATION
BLDG = BUILDING
BLK = BLOCK
BM = BENCH MARK
BNDY = BOUNDARY
BRG = BEARING
BWF = BARBED WIRE FENCE
C = CALCULATED
CB = CHORD BEARING
CBS = CONCRETE BLOCK STRUCTURE
CHD = CHORD
O.H. = OVERHEAD
CLF = CHAIN LINK FENCE
CLR = CLEARANCE
COL = COLUMN
CONC = CONCRETE
CP = COUNTY PENAL
C/S = CONCRETE SLAB
COR = CORNER
CVR = COVERED AREA
D = DEED
DOT = DEPARTMENT OF TRANSPORTATION
DW = DRIVEWAY
DWY = DRIVEWAY
EL OR ELEV = ELEVATION
EOP = EDGE OF PAVEMENT
EOW = EDGE OF WATER
ESMT = EASEMENT
FCM = FOUND CONCRETE MONUMENT
FCS = FLARED END SECTION
FIP = FOUND IRON PIPE
FIR = FOUND IRON ROD
FL = FLOW LINE
FLD = FIELD
FND = FOUND
FOP = FOUND OPEN PIPE
FPC = FLORIDA POWER CORP.
FPP = FOUND PINCHED PIPE
FT = FEET
FZL = FLOOD ZONE LINE
GAR = GARAGE
G/S = GLASS ENCLOSURE
HWF = HOG WIRE FENCE
HWL = HIGH WATER LINE
INV = INVERT
LB = LAND SURVEYING BUSINESS
LFE = LOWEST FLOOR ELEV.
LSM = LICENSED SURVEYOR AND MAPPER
M = MEASURED
MBS = MASONRY
MCS = METERED END SECTION
MH = MANHOLE
MHW = MEAN HIGH WATER LINE
MSL = MEAN SEA LEVEL
NAIL = NAIL AND BOTTLE CAP
NAIL & DISK = NAIL AND DISK
NAIL & TAG = NAIL AND TAG
NGVD = NATIONAL GEODETIC VERTICAL DATUM
NO = NUMBER
O/A = OVERALL
OHW = OVERHEAD WIRE(S)
OR = OFFICIAL RECORDS
O/S = OFFSET
PLAT = PLAT
PB = PLAT BOOK
PC = POINT OF CURVE
PCC = POINT OF COMPOUND CURVE
PCP = PERMANENT CONTROL POINT
PG = PAGE
PK = PARKER KALON
PL = PROPERTY LINE
POB = POINT OF BEGINNING
POC = POINT OF COMMENCEMENT
POL = POINT ON LINE
PP = POWER POLE
PRC = POINT OF REVERSE CURVATURE
PRM = PERMANENT REFERENCE MONUMENT
PROP = PROPERTY
PSM = PROFESSIONAL SURVEYOR & MAPPER
PT = POINT OF TANGENCY
PVC = POINT OF VERTICAL CURVATURE
RBD = RADIUS
R = RECORD
REF = REFERENCE
RES = RESIDENCE
RL = RADIAL LINE
RLS = REGISTERED LAND SURVEYOR
RNG = RANGE
RWC = FENCE
RWL = RIVAL ROAD SPIKE
R/W = RIGHT-OF-WAY
SCM = SET CONCRETE MONUMENT
S.E. = CONCRETE ENCLOSURE
SEC = SECTION
SET NAIL = SET NAIL AND DISK LB# 1834
SIR = SET 1/2" IRON ROD LB# 1834
SQ = SQUARE
S/W = WOVEN SOLID FENCE
SW = STONE WALL
STY = STORY
SUB = SUBMERGED
S/W = SIDEWALK
TB = "T" BAR
TBM = TEMPORARY BENCH MARK
TC = TOP OF CURB
TEL = TELEPHONE
TOS = TOE OF SLOPE
TRANS = TRANSFORMER
TWP = TOWNSHIP
TYP = TYPICAL
UG = UNDERGROUND
UTIL = UTILITY
W = WATER
W/I = WOOD FENCE
WFS = WOOD FRAME STRUCTURE
WF = WROUGHT IRON FENCE
WIT = WITNESS
WWF = WIRE FENCE
WV = WATER VALVE

*** ABBREVIATIONS MAY ALSO BE CONCATENATED AS REQUIRED.
*** OTHER COMMONLY RECOGNIZED AND/OR ACCEPTED ABBREVIATIONS ARE ALSO UTILIZED BUT NOT SPECIFIED HEREON.

GENERAL NOTES

1.) THIS SURVEY HAS BEEN EXCLUSIVELY PREPARED FOR THE NAMED ENTITIES (THE "CERTIFIED PARTIES") SHOWN HEREON AND IS NOT TRANSFERABLE. NO OTHER PERSON OR ENTITY IS ENTITLED TO RELY UPON AND/OR RE-USE THIS SURVEY FOR ANY PURPOSE WITHOUT THE EXPRESSED, WRITTEN CONSENT OF GEORGE A. SHIMP II & ASSOCIATES, INC. (THE "SURVEY FIRM") AND THE CERTIFYING PROFESSIONAL SURVEYOR AND MAPPER (THE "SIGNING SURVEYOR"), HEREINAFTER COLLECTIVELY REFERRED TO AS "THE SURVEYOR". NOTHING HEREIN SHALL BE CONSTRUED TO GIVE ANY RIGHTS OR BENEFITS TO ANYONE OTHER THAN THE CERTIFIED PARTIES SHOWN ON THIS SURVEY.

2.) UNAUTHORIZED COPIES AND/OR REPRODUCTIONS VIA ANY MEDIUM OF THIS SURVEY OR ANY PORTIONS THEREOF ARE EXPRESSLY PROHIBITED WITHOUT THE SURVEYOR'S EXPRESSED, WRITTEN CONSENT.

3.) THE WORD "CERTIFY" AS SHOWN AND USED HEREON, MEANS AN EXPRESSION OF THE SURVEYOR'S OPINION REGARDING THE FACTS OF THE SURVEY BASED ON HIS BEST KNOWLEDGE, INFORMATION AND BELIEF, AND THAT IT THIS CONSTITUTES NEITHER A GUARANTEE NOR A WARRANTY, EITHER EXPRESSED OR IMPLIED.

4.) THIS SURVEY SHALL BE VALID FOR ONE (1) YEAR FROM THE DATE OF FIELD SURVEY SHOWN HEREON.

5.) THIS PROPERTY WAS SURVEYED BASED ON THE PROPERTY'S LEGAL DESCRIPTION, AS SHOWN HEREON, WHICH UNLESS OTHERWISE STATED, WAS PROVIDED TO THE SURVEYOR BY THE CLIENT, OR CLIENT'S DESIGNATED AGENT.

6.) THIS SURVEY WAS PREPARED WITHOUT THE BENEFIT OF AN ABSTRACT OF TITLE OR TITLE COMMITMENT AND IS SUBJECT TO ANY DEDICATIONS, LIMITATIONS, RESTRICTIONS, RESERVATIONS, EASEMENTS AND/OR OTHER MATTERS OF RECORD. NO INSTRUMENTS OF RECORD REFLECTING EASEMENTS, RIGHTS-OF-WAY, AND/OR OWNERSHIP WERE FURNISHED TO THE SURVEYOR, EXCEPT AS SHOWN.

7.) THE SURVEYOR HAS MADE NO INVESTIGATION OR INDEPENDENT SEARCH FOR EASEMENTS OF RECORD, ENCUMBRANCES, RESTRICTIVE COVENANTS, OWNERSHIP TITLE EVIDENCE OR ANY OTHER MATTERS OF RECORD THAT AN ACCURATE AND CURRENT TITLE SEARCH MAY DISCLOSE.

8.) THERE MAY BE ADDITIONAL EASEMENTS, RESERVATIONS, RESTRICTIONS AND/OR OTHER MATTERS OF RECORD AFFECTING THIS PROPERTY THAT ARE NOT SHOWN HEREON AND MAY (OR MAY NOT) BE FOUND IN THE PUBLIC RECORDS OF THIS COUNTY.

9.) MEASURED BEARINGS ARE IN REFERENCE TO FLORIDA STATE PLANE COORDINATE GRID NORTH, WEST ZONE, NORTH AMERICAN DATUM OF 1983 (2011 READJUSTMENT), AS ESTABLISHED BY THE NATIONAL GEODETIC SURVEY.

10.) THERE ARE NO VISIBLE ENCROACHMENTS, EXCEPT AS SHOWN HEREON.

11.) THIS SURVEY SHOWS VISIBLE, ABOVE GROUND FEATURES. NO UNDERGROUND FEATURES, INCLUDING BUT NOT LIMITED TO FOUNDATIONS, STRUCTURES, INSTALLATIONS OR IMPROVEMENTS HAVE BEEN LOCATED, EXCEPT AS SHOWN HEREON.

12.) ALL BUILDING TIES, PROPERTY MARKER LOCATIONS AND OTHER SITE IMPROVEMENT LOCATIONS SHOWN HEREON ARE MEASURED PERPENDICULAR TO ADJACENT BOUNDARY LINES, UNLESS OTHERWISE STATED.

13.) THE FLOOD ZONE DETERMINATION IS BASED ON THE FLOOD INSURANCE RATE MAP, AS PUBLISHED BY THE FEDERAL EMERGENCY MANAGEMENT AGENCY, AND DOES NOT IMPLY THAT THE PROPERTY WILL OR WILL NOT BE FREE FROM FLOODING AND DAMAGE. LARGER FLOODS THAN THOSE PREDICATED ON SAID MAP MAY OCCUR AND FLOOD HEIGHTS MAY BE INDICASED BY MAN-MADE OR NATURAL CAUSES. THE FLOOD INSURANCE RATE MAP "IS FOR INSURANCE PURPOSES ONLY" AND ANY DAMAGES THAT MAY RESULT FROM RELIANCE ON THIS FLOOD ZONE DETERMINATION SHALL NOT CREATE LIABILITY ON THE PART OF THE SURVEYOR. THE FLOOD ZONE LINES (IF ANY) SHOWN HEREON ARE APPROXIMATE AND ARE BASED UPON A SCALED INTERPRETATION FROM THE FLOOD INSURANCE RATE MAP AS PUBLISHED BY THE FEDERAL EMERGENCY MANAGEMENT AGENCY.

14.) UNLESS OTHERWISE SHOWN, THIS SURVEY DOES NOT REFLECT OR DETERMINE OWNERSHIP LINES, LINES AFFECTED BY ADVERSE USE, LINES OF CONFLICTING/OVERLAPPING DEEDS, OR OTHER LINES THAT MAY OTHERWISE BE DETERMINED BY A COURT OF LAW.

15.) NO INFORMATION ON ADJOINING PROPERTY OWNERS OR ADJOINING PROPERTY RECORDING INFORMATION WAS PROVIDED TO THE SURVEYOR.

16.) BECAUSE OF THE POSSIBILITY OF MOVEMENT OF THE MONUMENTATION FROM ITS ORIGINAL PLACEMENT BY PERSONS OTHER THAN THE SURVEYOR, IT IS RECOMMENDED THAT PRIOR TO ANY NEW IMPROVEMENTS ON THE PROPERTY THAT THE POSITION OF THE MONUMENTATION BE VERIFIED.

17.) FENCES AND WALLS (IF ANY) SHOWN ALONG THE BOUNDARIES OF THIS SURVEY ARE EXAGGERATED FOR CLARITY AND OWNERSHIP IS NOT DETERMINED. THE TIES AT THE PROPERTY CORNERS OR AT SPECIFICALLY DESIGNATED POINTS ARE BASED UPON FIELD LOCATIONS. FENCES AND WALLS ALONG OTHER PROPERTY BOUNDARIES MEANDER AND ARE APPROXIMATE. PRIOR TO THE RECONSTRUCTION OF ANY FENCES OR WALLS, IT WOULD BE PRUDENT TO HAVE THE BOUNDARY LINE STAKED.

18.) THE PRINTED DIMENSIONS SHOWN ON THIS SURVEY SUPERSEDE ANY SCALED DIMENSIONS. THERE MAY BE ITEMS DRAWN OUT OF SCALE TO GRAPHICALLY SHOW THEIR LOCATION.

19.) THIS SURVEY IS A REPRESENTATION OF EXISTING FIELD CONDITIONS AT THE TIME OF THE FIELD SURVEY AND UNLESS OTHERWISE SHOWN, IS BASED ON EXISTING SURVEY MONUMENTATION AS FOUND IN THE FIELD.

20.) THE ACCURACY OF THIS SURVEY, AS OBTAINED BY FIELD-MEASURED CONTROL MEASUREMENTS AND CALCULATIONS, MEETS OR EXCEEDS THE MINIMUM RELATIVE DISTANCE ACCURACY REQUIREMENT AS SPECIFIED IN THE MINIMUM TECHNICAL STANDARDS (5J-17, FLORIDA ADMINISTRATIVE CODE).

21.) THIS SURVEY IS BEING CERTIFIED ACCORDING TO THE LAST DATE OF FIELD SURVEY AND NOT THE SIGNATURE DATE (IF ANY).

22.) THIS SURVEY SHALL NOT BE FILED FOR PUBLIC RECORDS WITHOUT THE KNOWLEDGE AND THE EXPRESSED, WRITTEN CONSENT OF THE SURVEYOR.

23.) UNLESS OTHERWISE SHOWN, THE DIMENSIONS SHOWN HEREON ARE IN FEET AND DECIMAL PARTS THEREOF AND ARE BASED ON THE DEFINITION OF A FOOT AS ADOPTED BY THE UNITED STATES BUREAU OF STANDARDS AND REFER TO THE HORIZONTAL PLANE.

24.) TREES BY NATURE ARE IRREGULAR IN SHAPE AND SIZE AND EVERY EFFORT IS MADE TO ACCURATELY LOCATE THEM. THE TREE SIZE IS DETERMINED AT CHEST HEIGHT DIAMETER AND THE TREE LOCATION IS CENTER OF THE TREE TRUNK. ANY TREE LOCATIONS THAT ARE CRITICAL TO DESIGN SHOULD BE FIELD VERIFIED. EVERY EFFORT HAS BEEN MADE TO PROPERLY IDENTIFY THE TREES SHOWN HEREON. HOWEVER, TREE IDENTIFICATION IS OUTSIDE THE AREA OF EXPERTISE OF A PROFESSIONAL SURVEYOR AND MAPPER, THEREFORE, THE SURVEYOR ACCEPTS NO RESPONSIBILITY FOR IDENTIFICATION OF TREE SPECIES. ALL TREE TYPES SHOWN ARE FOR INFORMATIONAL PURPOSES ONLY AND ANY TREE SPECIES THAT ARE CRITICAL SHOULD BE VERIFIED BY A CERTIFIED ARBORIST.

25.) THIS SURVEY SHALL NOT BE USED WITH A SURVEY AFFIDAVIT. AN INCORRECT SURVEY AFFIDAVIT CAN INCREASE THE OWNER/BUYER'S LIABILITY, DECREASE THEIR LEGAL RIGHTS AND PROTECTIONS WHICH ARE AFFORDED BY A CURRENT SURVEY AND MAY RESULT IN COSTLY LITIGATION AS WELL. AN INCORRECT SURVEY AFFIDAVIT CAN BE THE RESULT OF CHANGES MADE TO THE PROPERTY SINCE THE DATE OF THE LAST SURVEY, WHICH MAY INCLUDE IMPROVEMENTS MADE BY THE OWNER, ADJACENT OWNERS OR UTILITY COMPANIES OR CHANGES IN THE SURVEY BOUNDARY MONUMENTATION. USE OF THIS SURVEY BY A LENDING INSTITUTION OR TITLE COMPANY IN CONJUNCTION WITH A SURVEY AFFIDAVIT IS STRICTLY PROHIBITED AND SHALL RENDER THIS SURVEY NULL AND VOID.

26.) THE ELEVATIONS SHOWN HEREON ARE BASED ON THE NORTH AMERICAN VERTICAL DATUM OF 1988 (NAVD 1988) AS ESTABLISHED FROM N.G.S. BENCH MARK "INNISBROOK J", WITH AN ELEVATION OF 9.23 FEET N.A.V.D. 1988.

LEGEND

- BASKETBALL HOOP
- BOLLARD
- BACKFLOW PREVENTER
- ELECTRIC BOX
- ELEVATION
- FIRE HYDRANT
- GAS VALVE
- GRATE INLET
- MAIL BOX
- POWER POLE
- RECLAIMED WATER METER
- RECLAIMED WATER VALVE
- SANITARY SEWER MANHOLE
- SEWER CLEAN OUT
- SIGN
- TELCOM SATELLITE DISH
- TELCOM PEDESTAL
- TELCOM VAULT
- WATER METER
- WATER VALVE
- WELL
- GUY WIRE
- HAND RAIL
- TOP OF BANK
- OVERHEAD WIRES
- U.G. FIRE LINE
- U.G. STORM SEWER LINE
- U.G. WATER LINE
- 0.7' UPRIGHT CURB
- CHERRY LAUREL
- CHINABERRY
- MIMOSA
- OAK
- PALM
- UNKNOWN
- UNKNOWN #1
- R/W - INFORMATION DERIVED FROM F.D.O.T. R/W MAP #15020-000 SEGMENT # 403725-1

LINE L1
S02°57'49"W - 12.01'RW
S03°03'51"W - 12.07'M

LINE L2
N00°02'00"E - 50.00'RW
N00°02'56"E - 49.97'M

LINE L3
N01°21'21"W - 110.22'M; 110'R

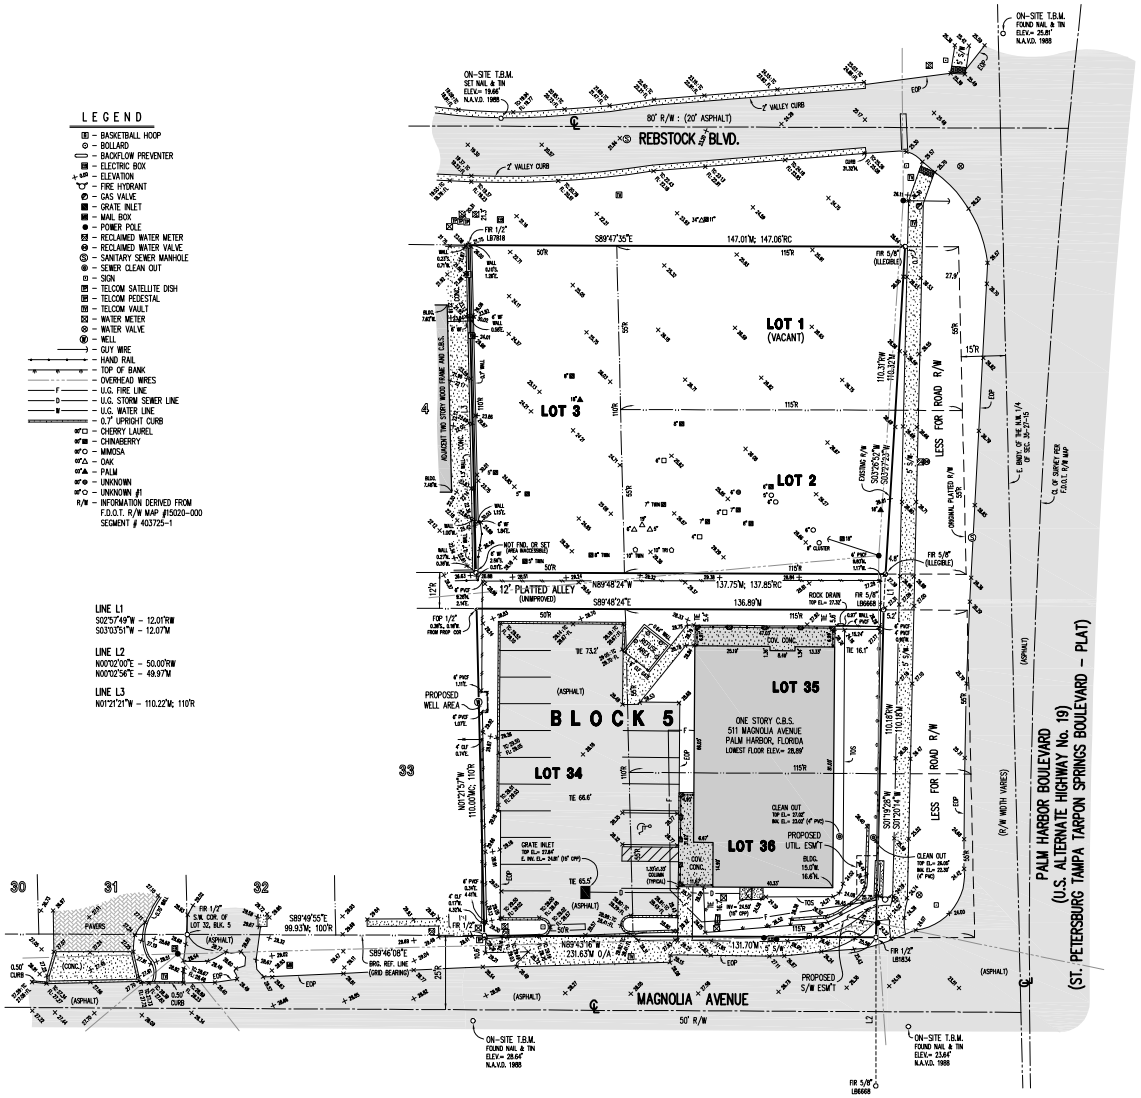

ZON-22-02

ASBUILT SURVEY

CERTIFICATION: I HEREBY CERTIFY TO THE BEST OF MY KNOWLEDGE AND BELIEF THAT THE SURVEY SHOWN HEREON SUBSTANTIALLY MEETS THE STANDARDS OF PRACTICE FOR LAND SURVEYING DESCRIBED IN THE STATE OF FLORIDA RULE 5J-17, F.A.C. FURTHERMORE, THIS CERTIFICATION SHALL NOT EXTEND TO ANY OTHER PERSONS OR PARTIES OTHER THAN THOSE NAMED ON THIS SURVEY AND SHALL NOT BE VALID AND BINDING AGAINST THE UNDERSIGNED SURVEYOR WITHOUT THE ORIGINAL RAISED SEAL AND SIGNATURE OF THE FLORIDA LICENSED SURVEYOR AND MAPPER.

UNOFFICIAL COPY
FOR INFORMATIONAL PURPOSES ONLY FOR THE CERTIFIED PARTIES

JOB NUMBER: 140244L	DATE SURVEYED: 11-29-2021
DRAWING FILE: 140244L.DWG	DATE DRAWN: 12-13-2021
LAST REVISION: N/A	X REFERENCE: N/A

S.G.
LB 1834

GEORGE A. SHIMP II AND ASSOCIATES, INCORPORATED
LAND SURVEYORS LAND PLANNERS
3991 DeSOTO BOULEVARD, SUITE D
PALM HARBOR, FLORIDA 34683
PHONE (727) 784-5406 FAX (727) 786-1894

© COPYRIGHT 2021
ALL RIGHTS RESERVED
George A. Shimp II & Associates, Inc.
Anyone copying this document in any manner without the expressed consent of GEORGE A. SHIMP II & ASSOCIATES, INC. shall be prosecuted to the full extent of the law.
DO NOT COPY OR REPRODUCE